

DRAWING NUMBER
593.013
CANTOR FITZGERALD
9/10/91
105 P-11
JOHN C. WESTRICK & ASSOCIATES
CONSULTING ENGINEERS
2110 MAPLE AVE. SOUTH PLAINFIELD, N.J.
07080
201 561-4170

IF THIS DRAWING IS NOT 24" X 36" IT IS A REDUCED PRINT SCALE ACCORDINGLY

JUSTIN PC
200 LEXINGTON AVE
NEW YORK, NY 10016
TEL (212) 689 9550

JOHN C. WESTRICK & ASSOCIATES
CONSULTING ENGINEERS
2110 MAPLE AVE. SOUTH PLAINFIELD, N.J.
07080
201 561-4170

DATE	ISSUED TO	PR	TR
3/22/91	PORT AUTHORITY FOR APPROVAL	10	1
3/22/91	CFSC FOR RECORD	5	4
1/19/91	CFSC	1	1
5-9-91	P.A. FOR APPROVAL	10	-
5/30/91	P.A. FOR APPROVAL	6	1
5/17/91	CFSC	1	-
5/19/91	PORT AUTHORITY	10	1
10-21-91	P.A. AS BUILT DRAWING	-	1


AS BUILT DRAWING
SIGNATURE: [Signature]
DATE: 8-6-91
JUSTIN PC ARCHITECTS

NO.	DATE	REVISION	BY
Δ	4/8/91	ADDED DETAILS 10, 11 & 12 PER P.A. COMMENTS	T.L.

CANTOR, FITZGERALD
SECURITIES CORP.
105th FLOOR
ONE WORLD TRADE CENTER, NEW YORK, N.Y.


PROPOSED NEW TRADING ROOM
FOR INVESTMENT STRATEGIES
CEILING, DETAILS & CABINETWORK
DETAILS - SPACE NO. 9

PROJECT NO. 706
SCALE AS NOTED
DRAWN BY T.L.
CHECKED BY JFP
DATE: MARCH 22, 1991
DRAWING NO. 105P 12

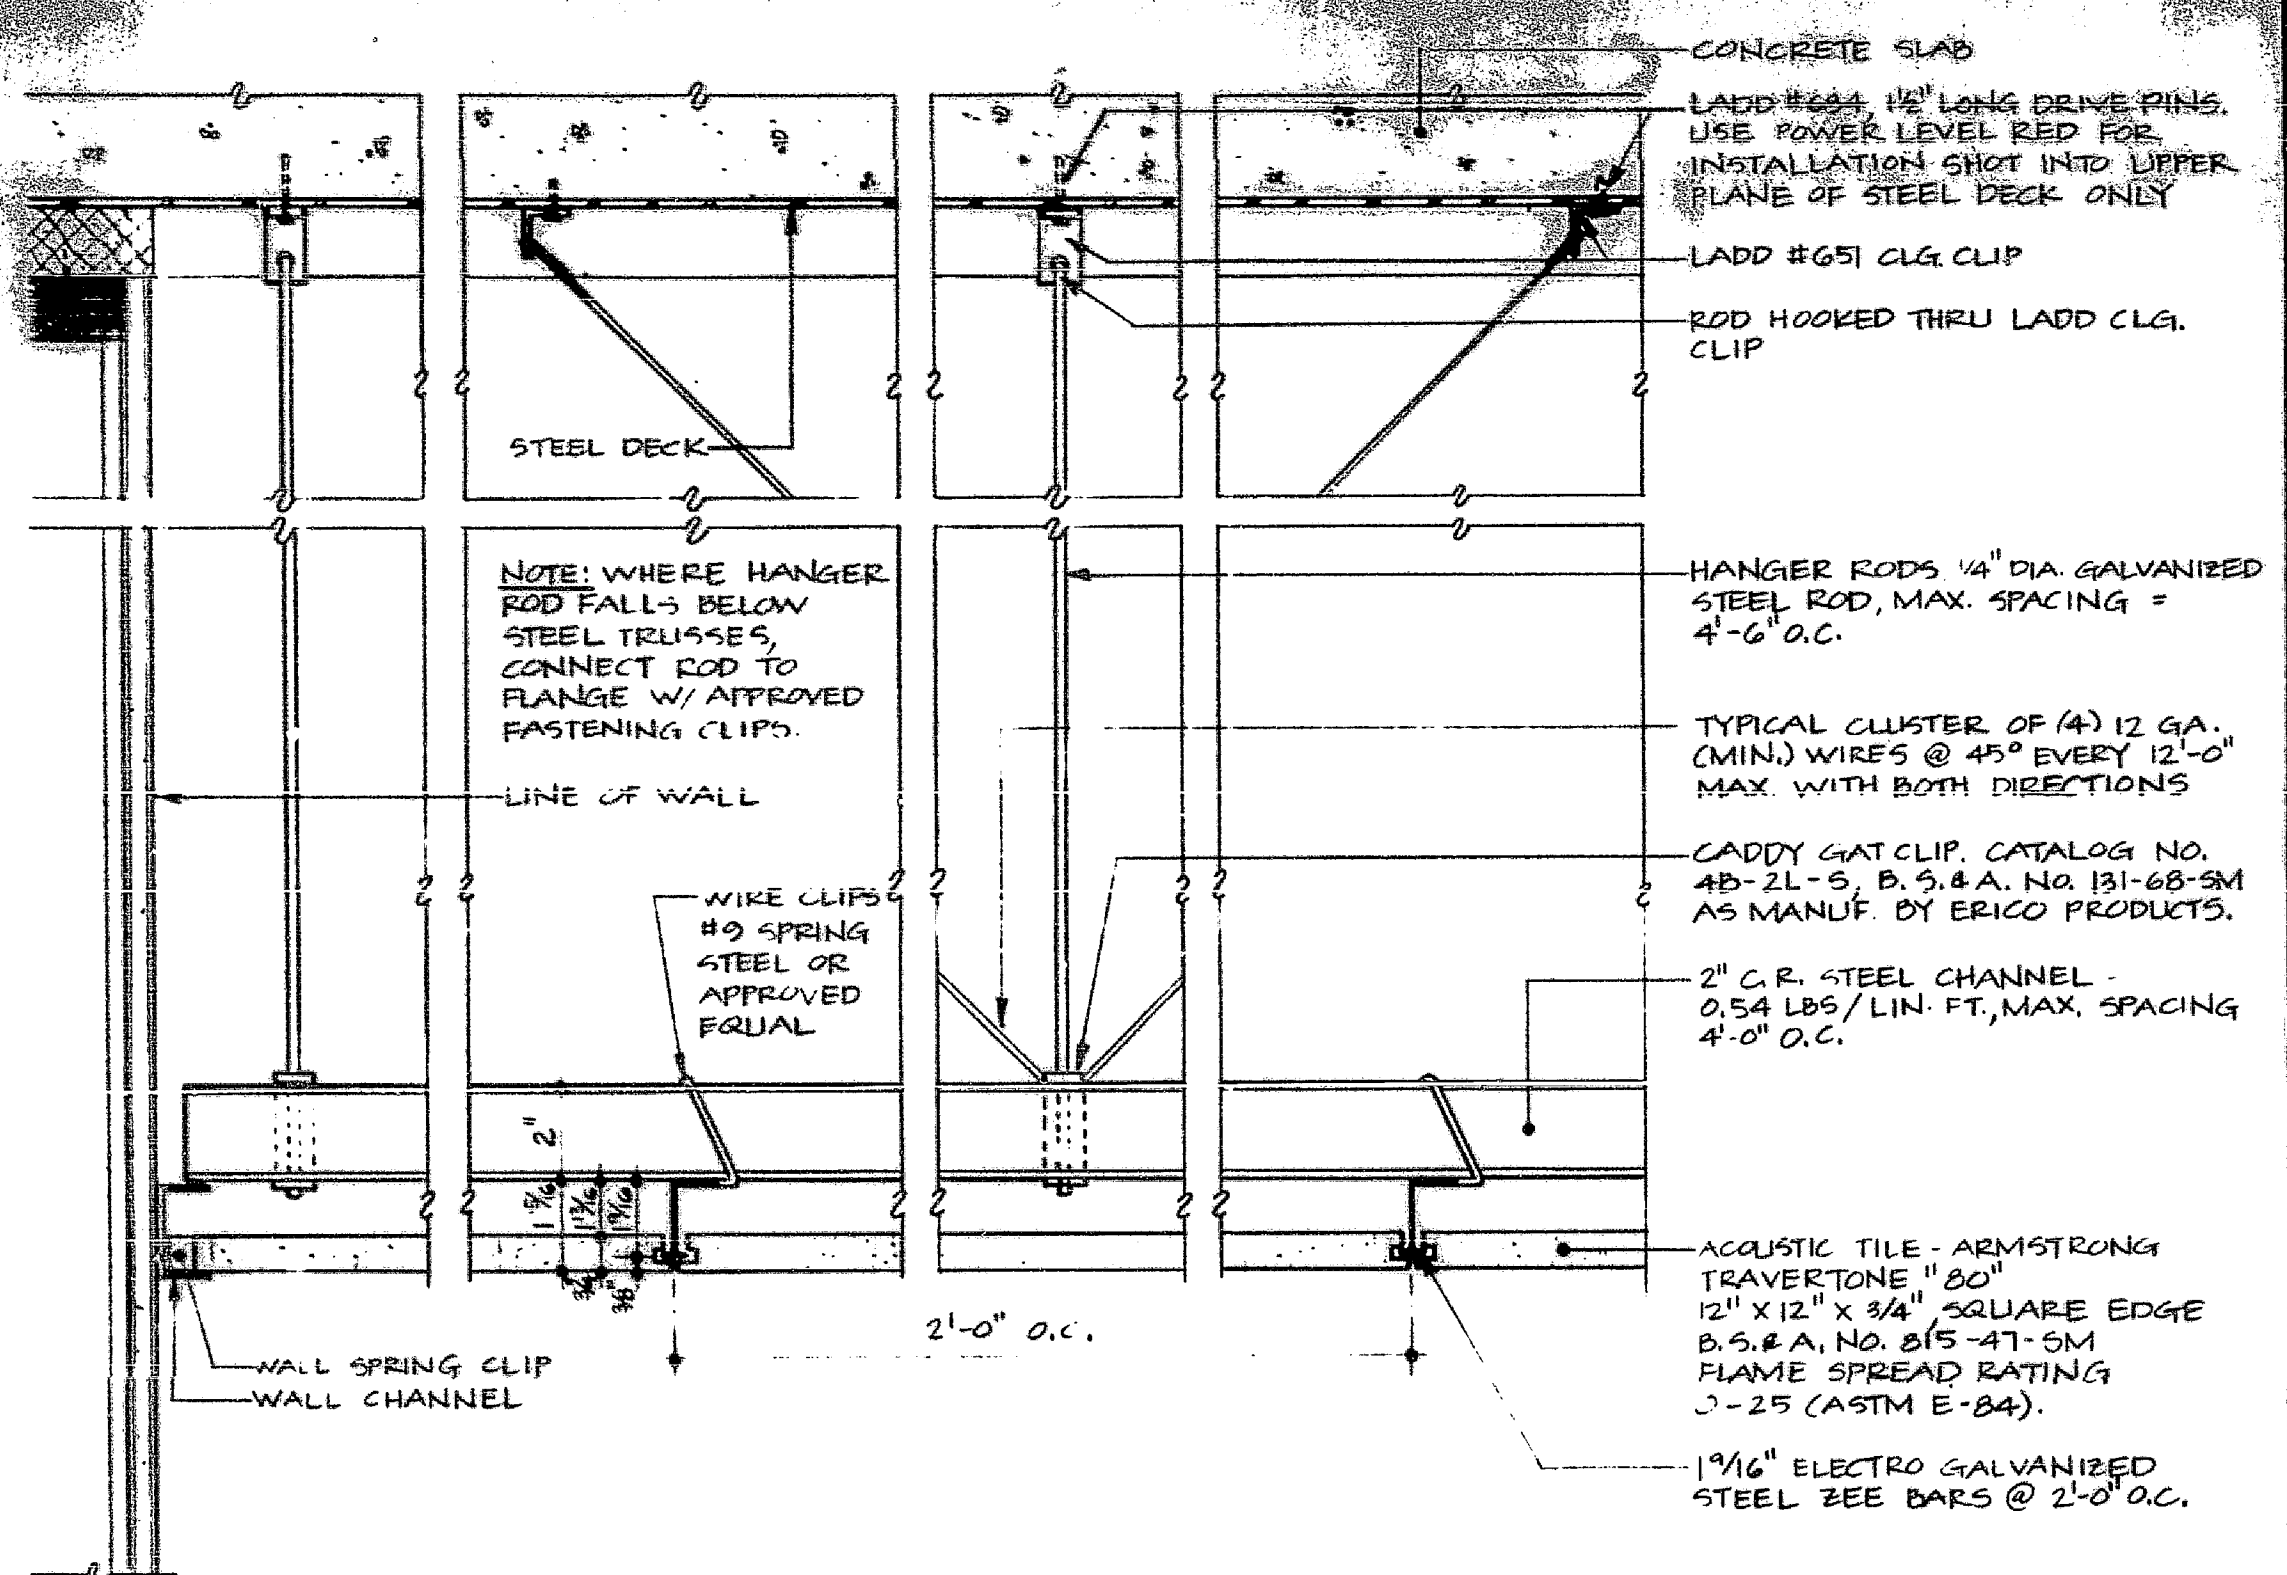


1 TYPICAL DETAIL SUSPENDED CONCEALED SPLINE CEILING

NOTE: SUSPENDED CEILING SYSTEM SHALL COMPLY WITH NYC BUILDING CODE SECTION C26-504.12 REFERENCE STANDARD #RS 5-16.

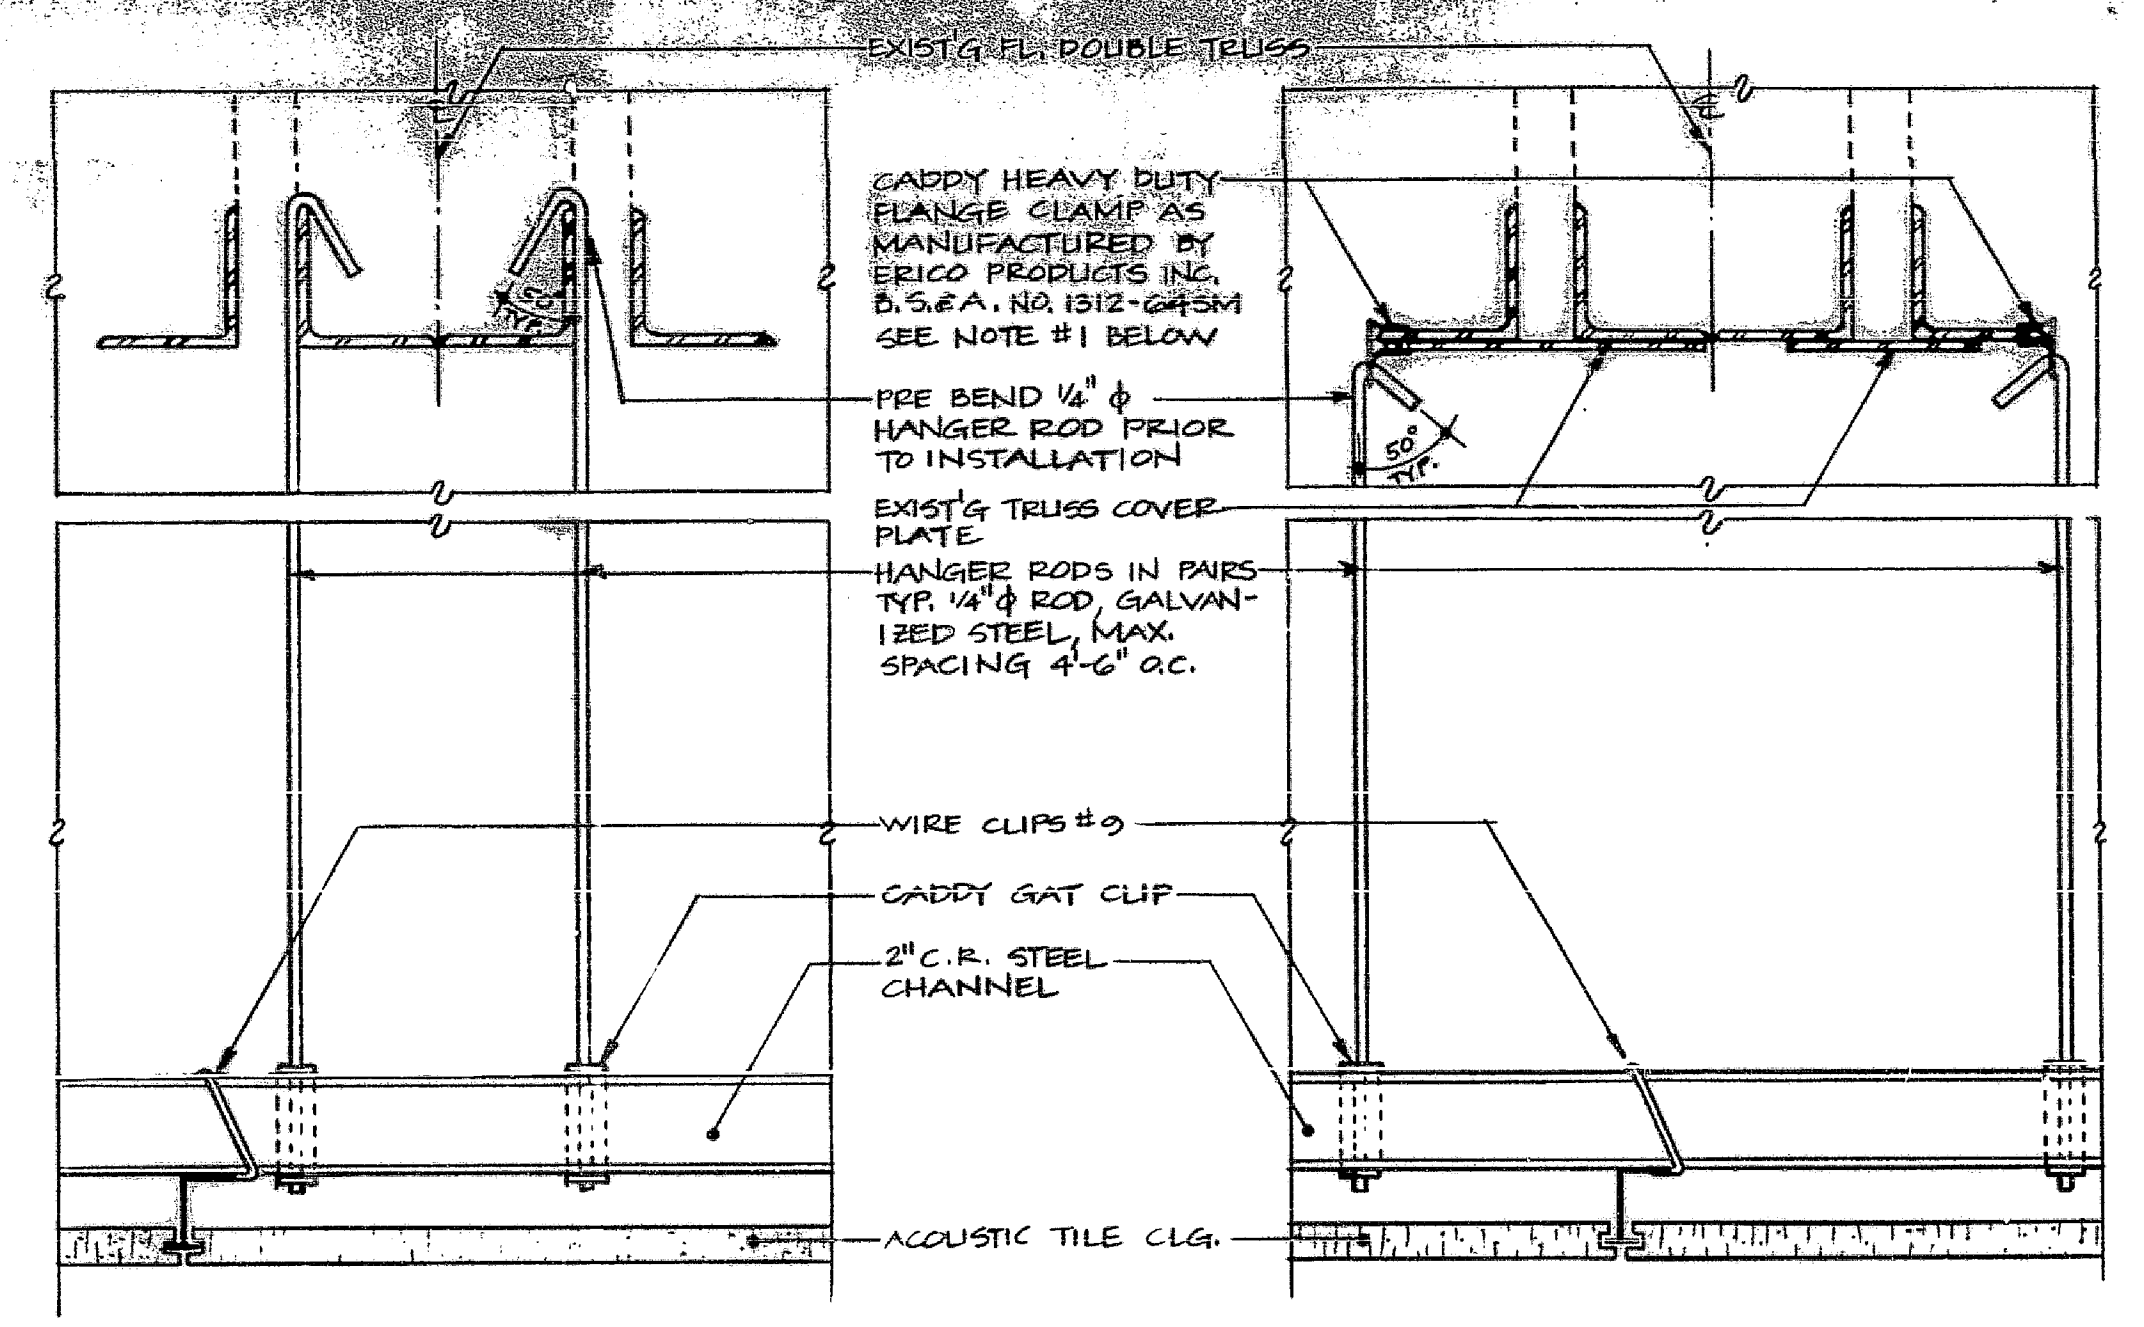


2 DETAIL OF HANGER SUPPORTS BELOW TRUSSES

NOTE #1: IF THICKNESS OF BOTTOM FLANGE OF TRUSS > 0.75" USE UNIVERSAL C-CLAMP (WIDE THROAT) 0.41 LBS. EACH AS MANUFACTURED BY GRINNELL CORP. OR APPROVED EQUAL. INSTALL C-CLAMP WITH SET SCREW IN TOP POSITION.

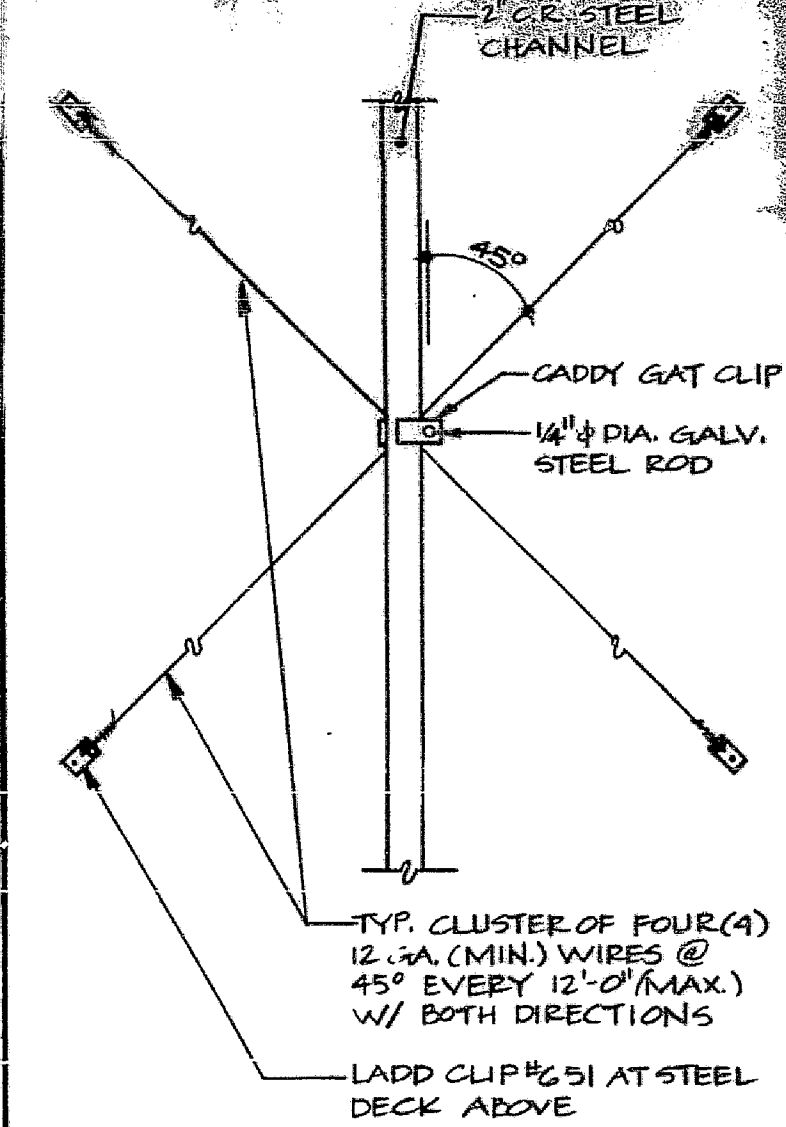


PLAN AT 1/4" PENCIL ROD HANGER W/ WIRE BRACING @ 1/2" = 1'-0"

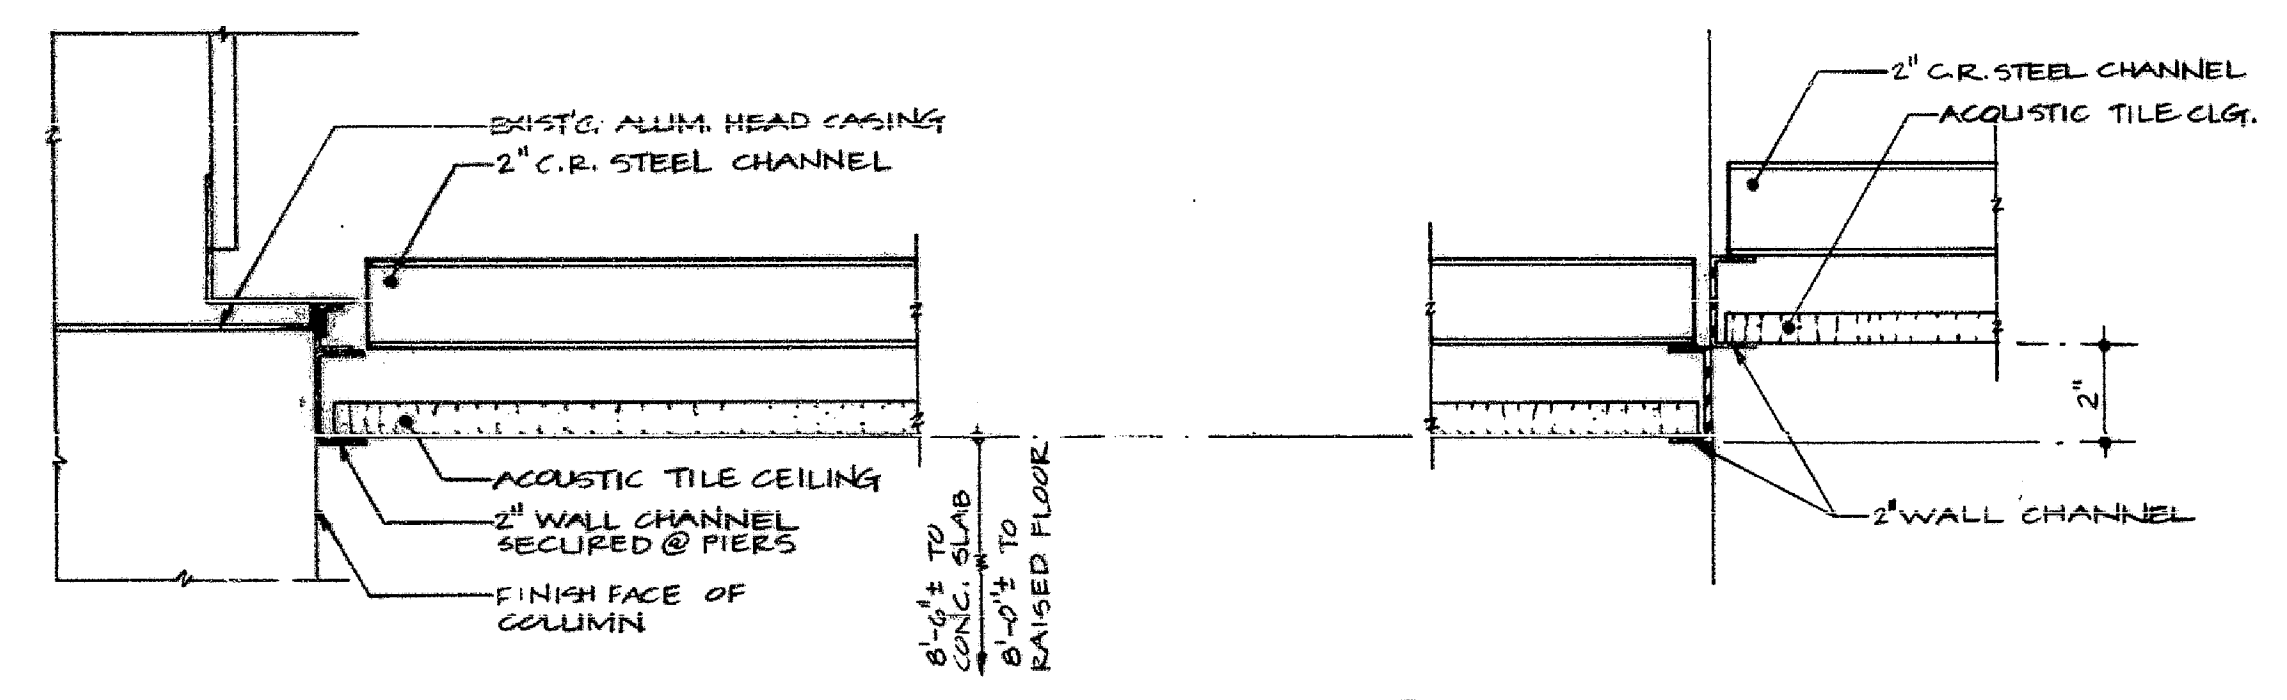


3 @ 3" = 1'-0"

4 @ 3" = 1'-0"

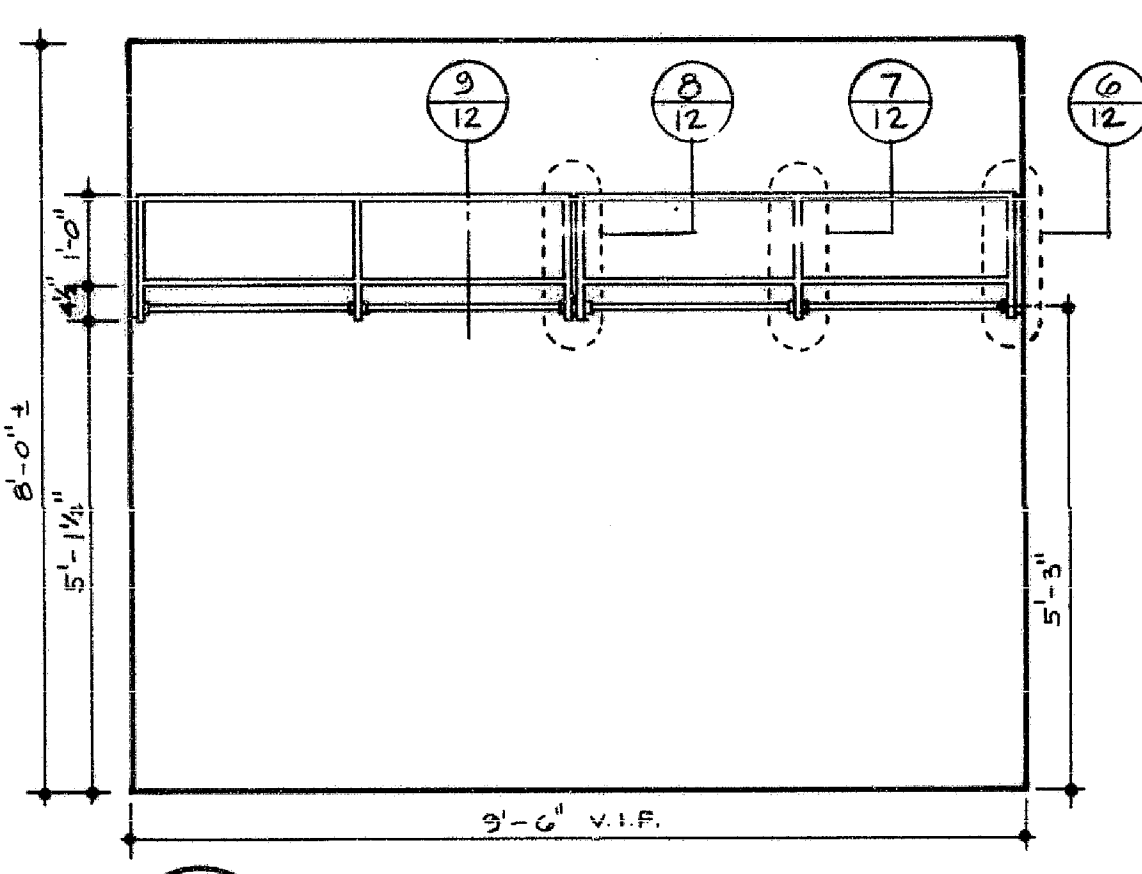


5 @ 1/2" = 1'-0"

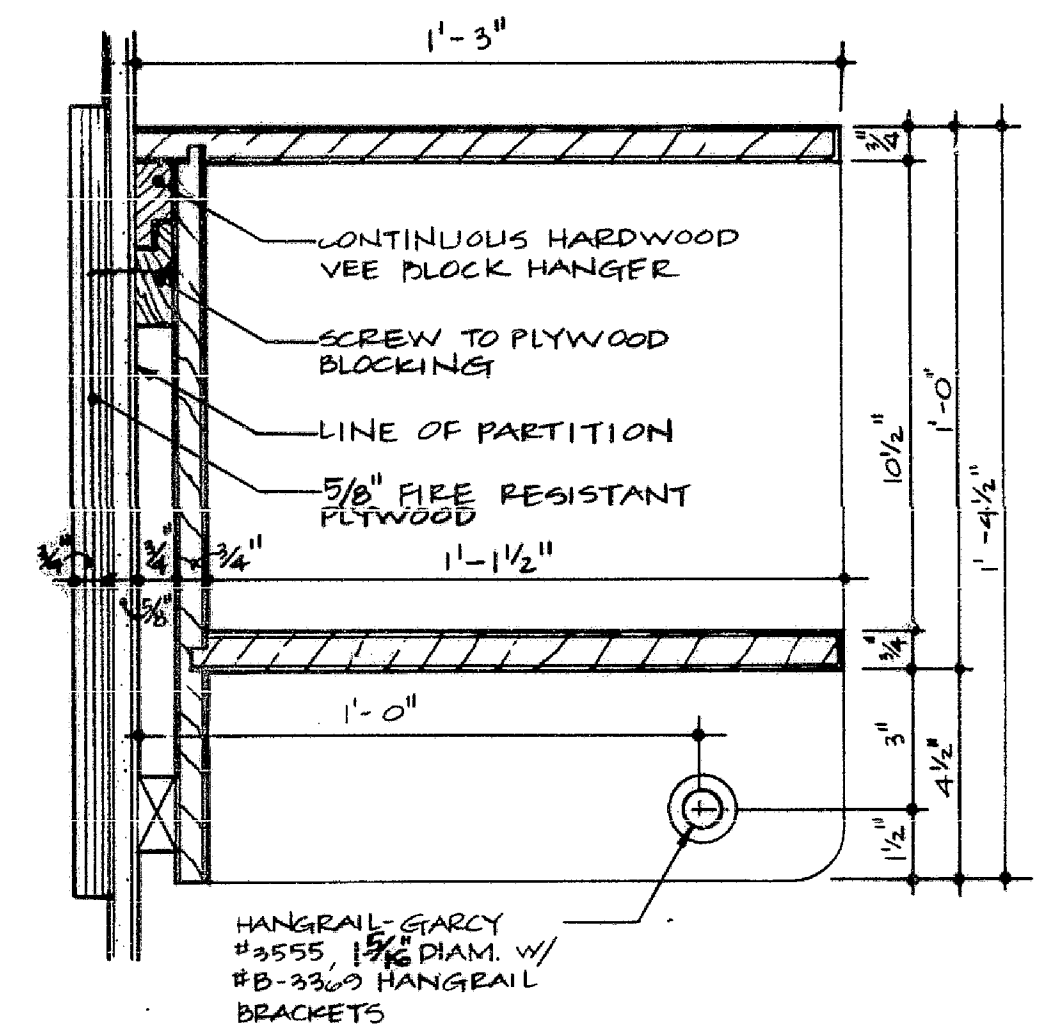


9 @ 3" = 1'-0"

ALL WOOD TO BE WHITE BIRCH NATURAL LACQUER FINISH

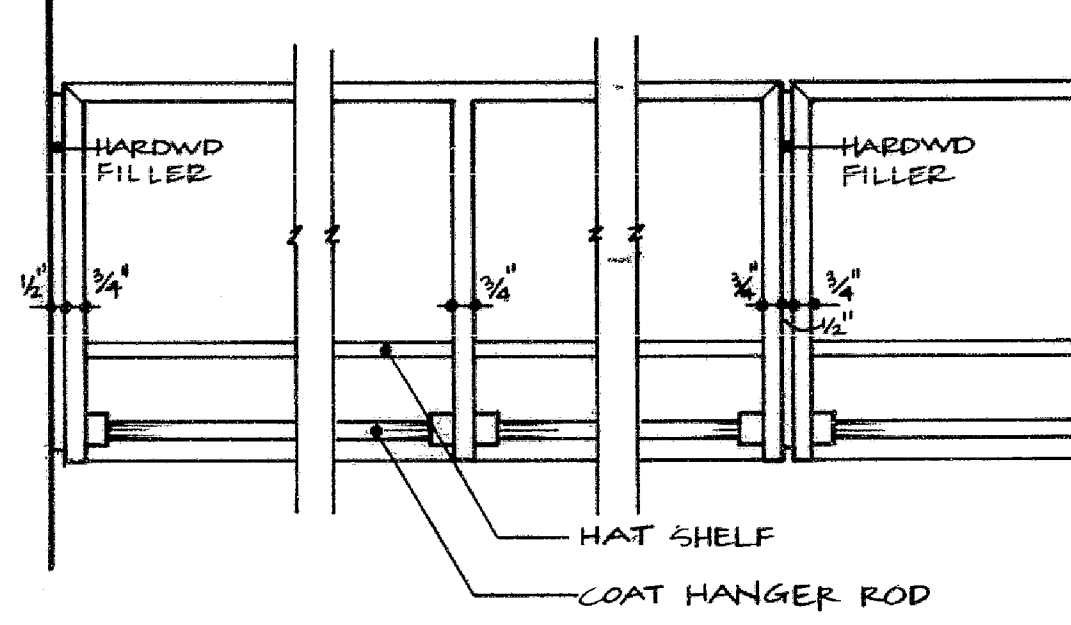

6 7 8 @ 3" = 1'-0"

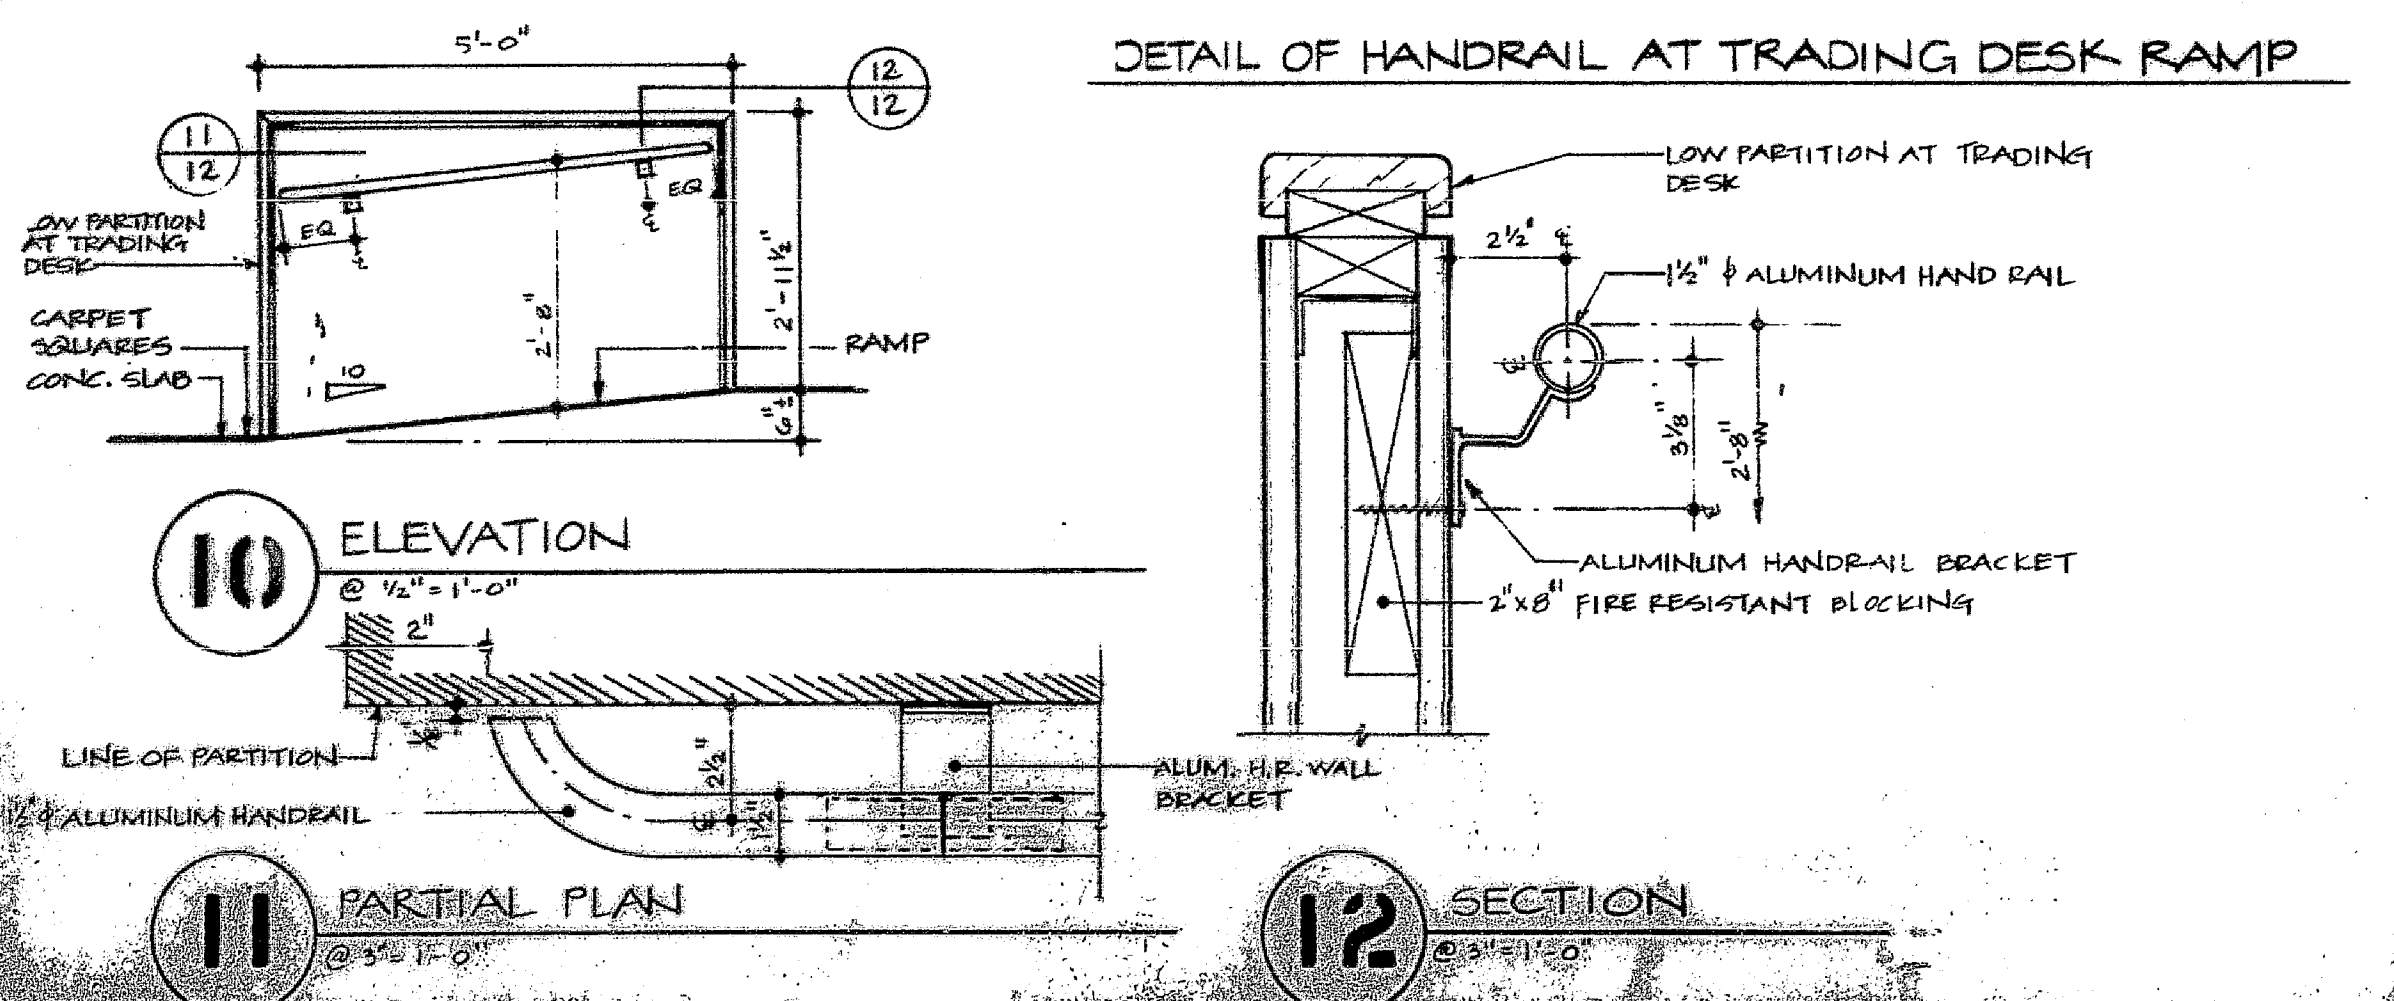

10 ELEVATION @ 1/2" = 1'-0"

12 SECTION @ 3/4" = 1'-0"

LIST OF MEA OR BS & A RESOLUTION NUMBERS FOR WOODWORK & CABINETWORK MATERIALS

- CORE CONSTRUCTION OF FRAMEWORK
FIRE RETARDANT LIAN MEA 124-85
- CORE CONSTRUCTION FOR LAMINATE
DURAFLAME "FE" MEA 177-12M
- SOLID MATERIAL
FIRE RETARDANT BASSWOOD MEA 123-85 UNDERWRITER'S LABORATORY REG. 14PB
- PLASTIC LAMINATE
CLASS "A" NEMA GRADE FR-50 FOR LAMINATION TO FIRE RETARDANT CORE 3/8" OR THICKER
ADHESIVE G 1149A, G-1131B FLAME SPREAD = 20, SMOKE DEVELOPED READING = 15 U.L. 723, ASTM E-85 TEST METHOD.

CABINETWORK NOTES

- CABINETWORK CONTRACTOR SHALL SET, BLOCK BEHIND, LEVEL, SHIM, & BOLT TOGETHER ALL STEEL FILE CABINETS. CABINETS WILL BE SUPPLIED BY OWNER.

PHASE
P
T.A.A. NO. W91051

